



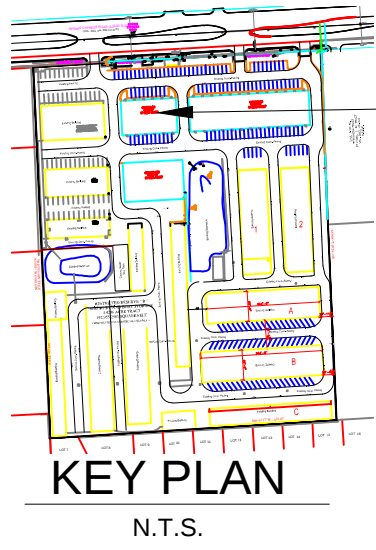

BUILDING LOCATION

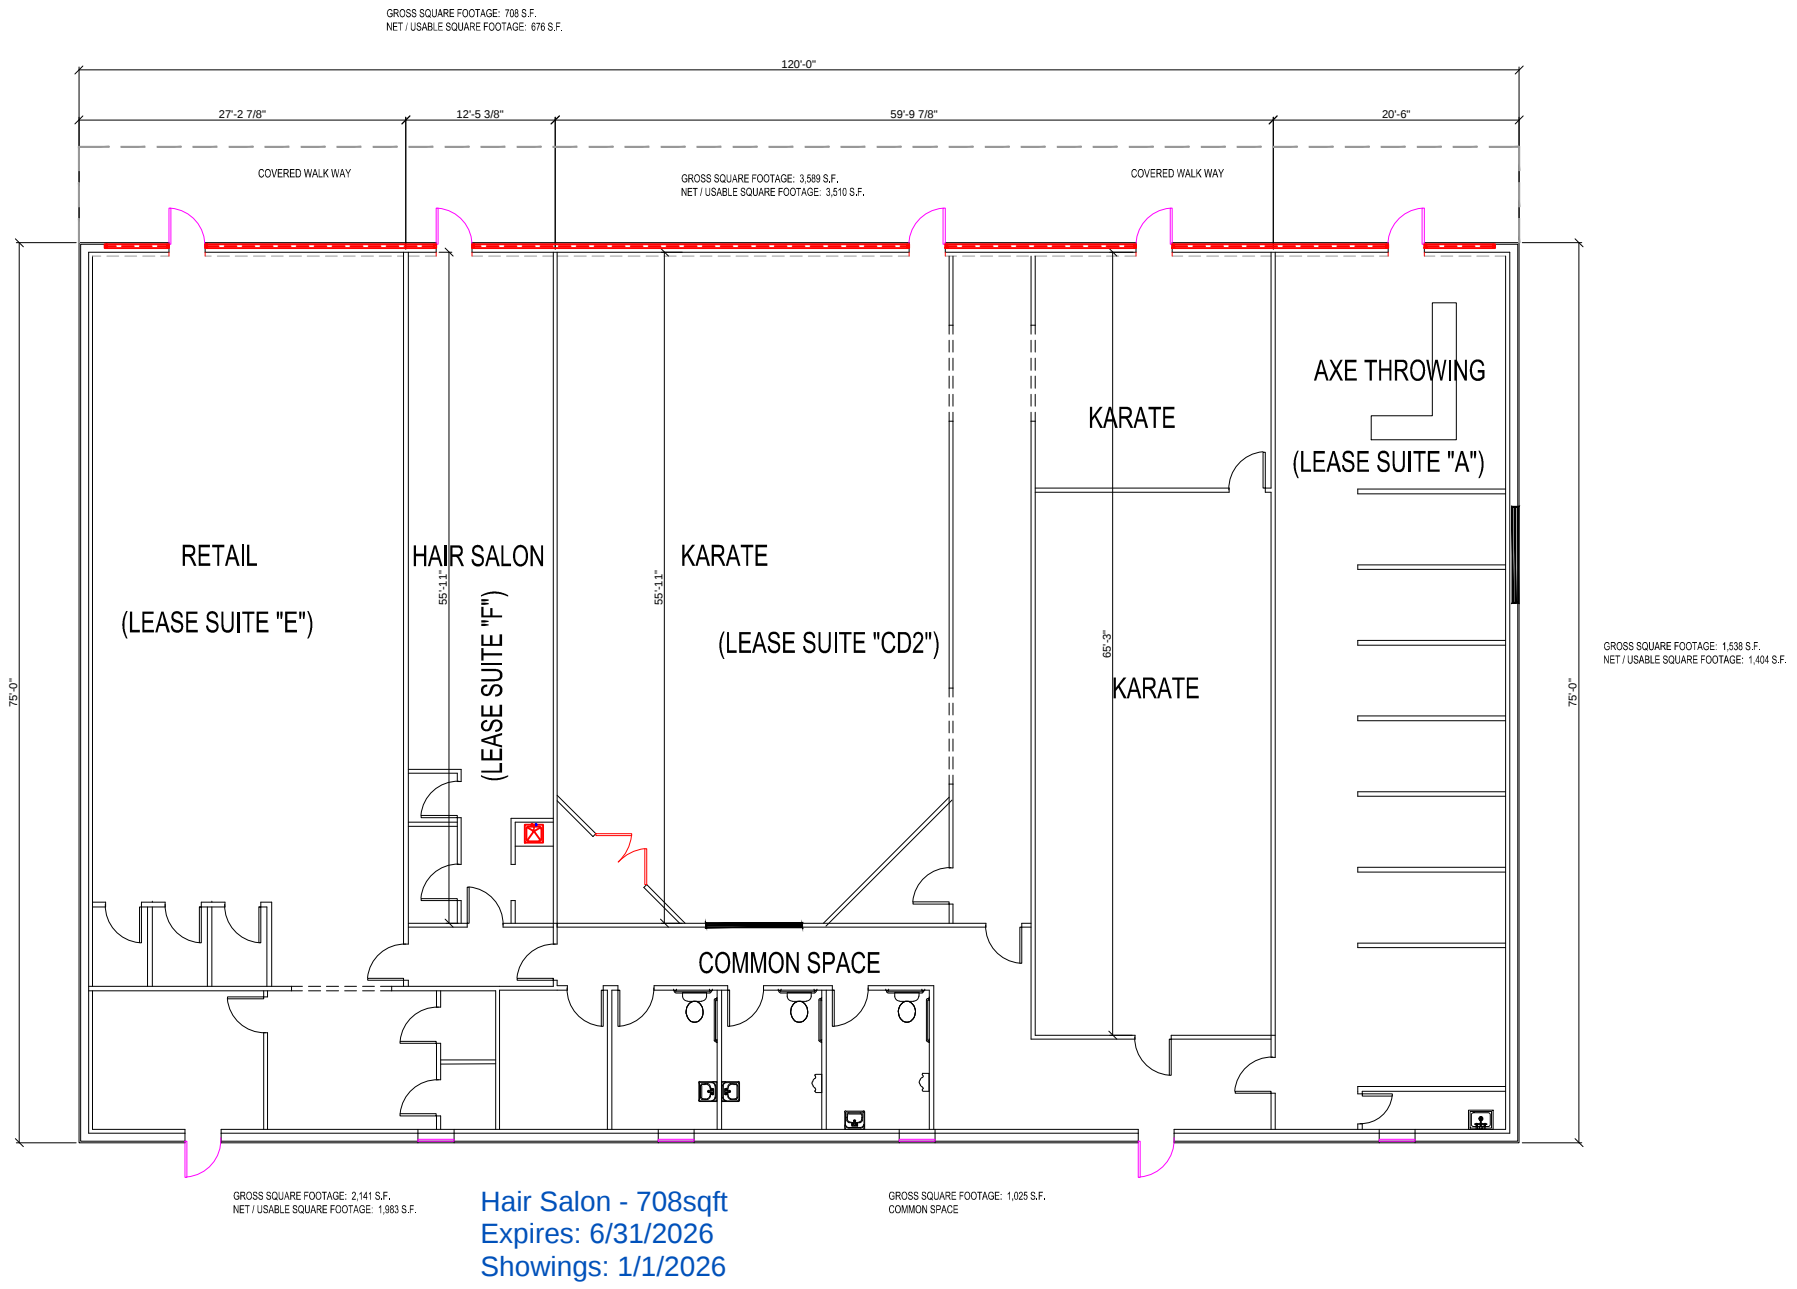

Drawings Prepared By:
Maloney Services
832.257.4619
maloneyservices@yahoo.com

PLAZA ONE
AS BUILT PLANS
11715 - 11719A SPRING CYPRESS
TOMBALL, TEXAS 77377

MALONEY SERVICES L.L.C. 2025. THIS OFFICE ASSUMES NO LIABILITY FOR ERRORS OR OMISSIONS ON THESE PLANS. ALL INFORMATION MUST BE CONFIRMED PRIOR TO COMMENCEMENT OF CONSTRUCTION. IT IS THE OWNERS AND BUILDERS RESPONSIBILITY TO OBTAIN ALL NECESSARY PERMITS AND TO FULLY COMPLY WITH ALL GOVERNING CODE REQUIREMENTS FOR THE GEOGRAPHIC AREA IN WHICH THIS PROJECT IS TO BE CONSTRUCTED.

Issue:
AS-BUILT DRAWINGS 10-27-2025

Date
10-27-2025

Project Number
08242025

Sheet Name
BUILDING PLAN

Sheet Number
A1.10