


OCCUPATION SUMMARY	
OPEN PLAN	20
(LEGAL OPEN PLAN)	2
(HR DESKS)	3
GLOBAL HR OFFICE	1
COMMS OFFICE	2
GENERAL / ADMIN OFFICE	1
FINANCE & TREASURY OFFICE	2
HOT OFFICE	4
CEO OFFICE	1
EXEC OFFICE	4
PA OFFICE	2
<b>TOTAL</b>	<b>32</b>

BOARDROOM (18)	1
MEETING ROOM (7)	1
MEETING ROOM (3)	1
QUIET BOOTHS	6
LOUNGE & BREAKOUT	1
TEA POINT	2
COPY & PRINT	2
COMMS ROOM	1
STORE	3

TOTAL FLOOR AREA	SQ M	SQ FT
	808.26	8700

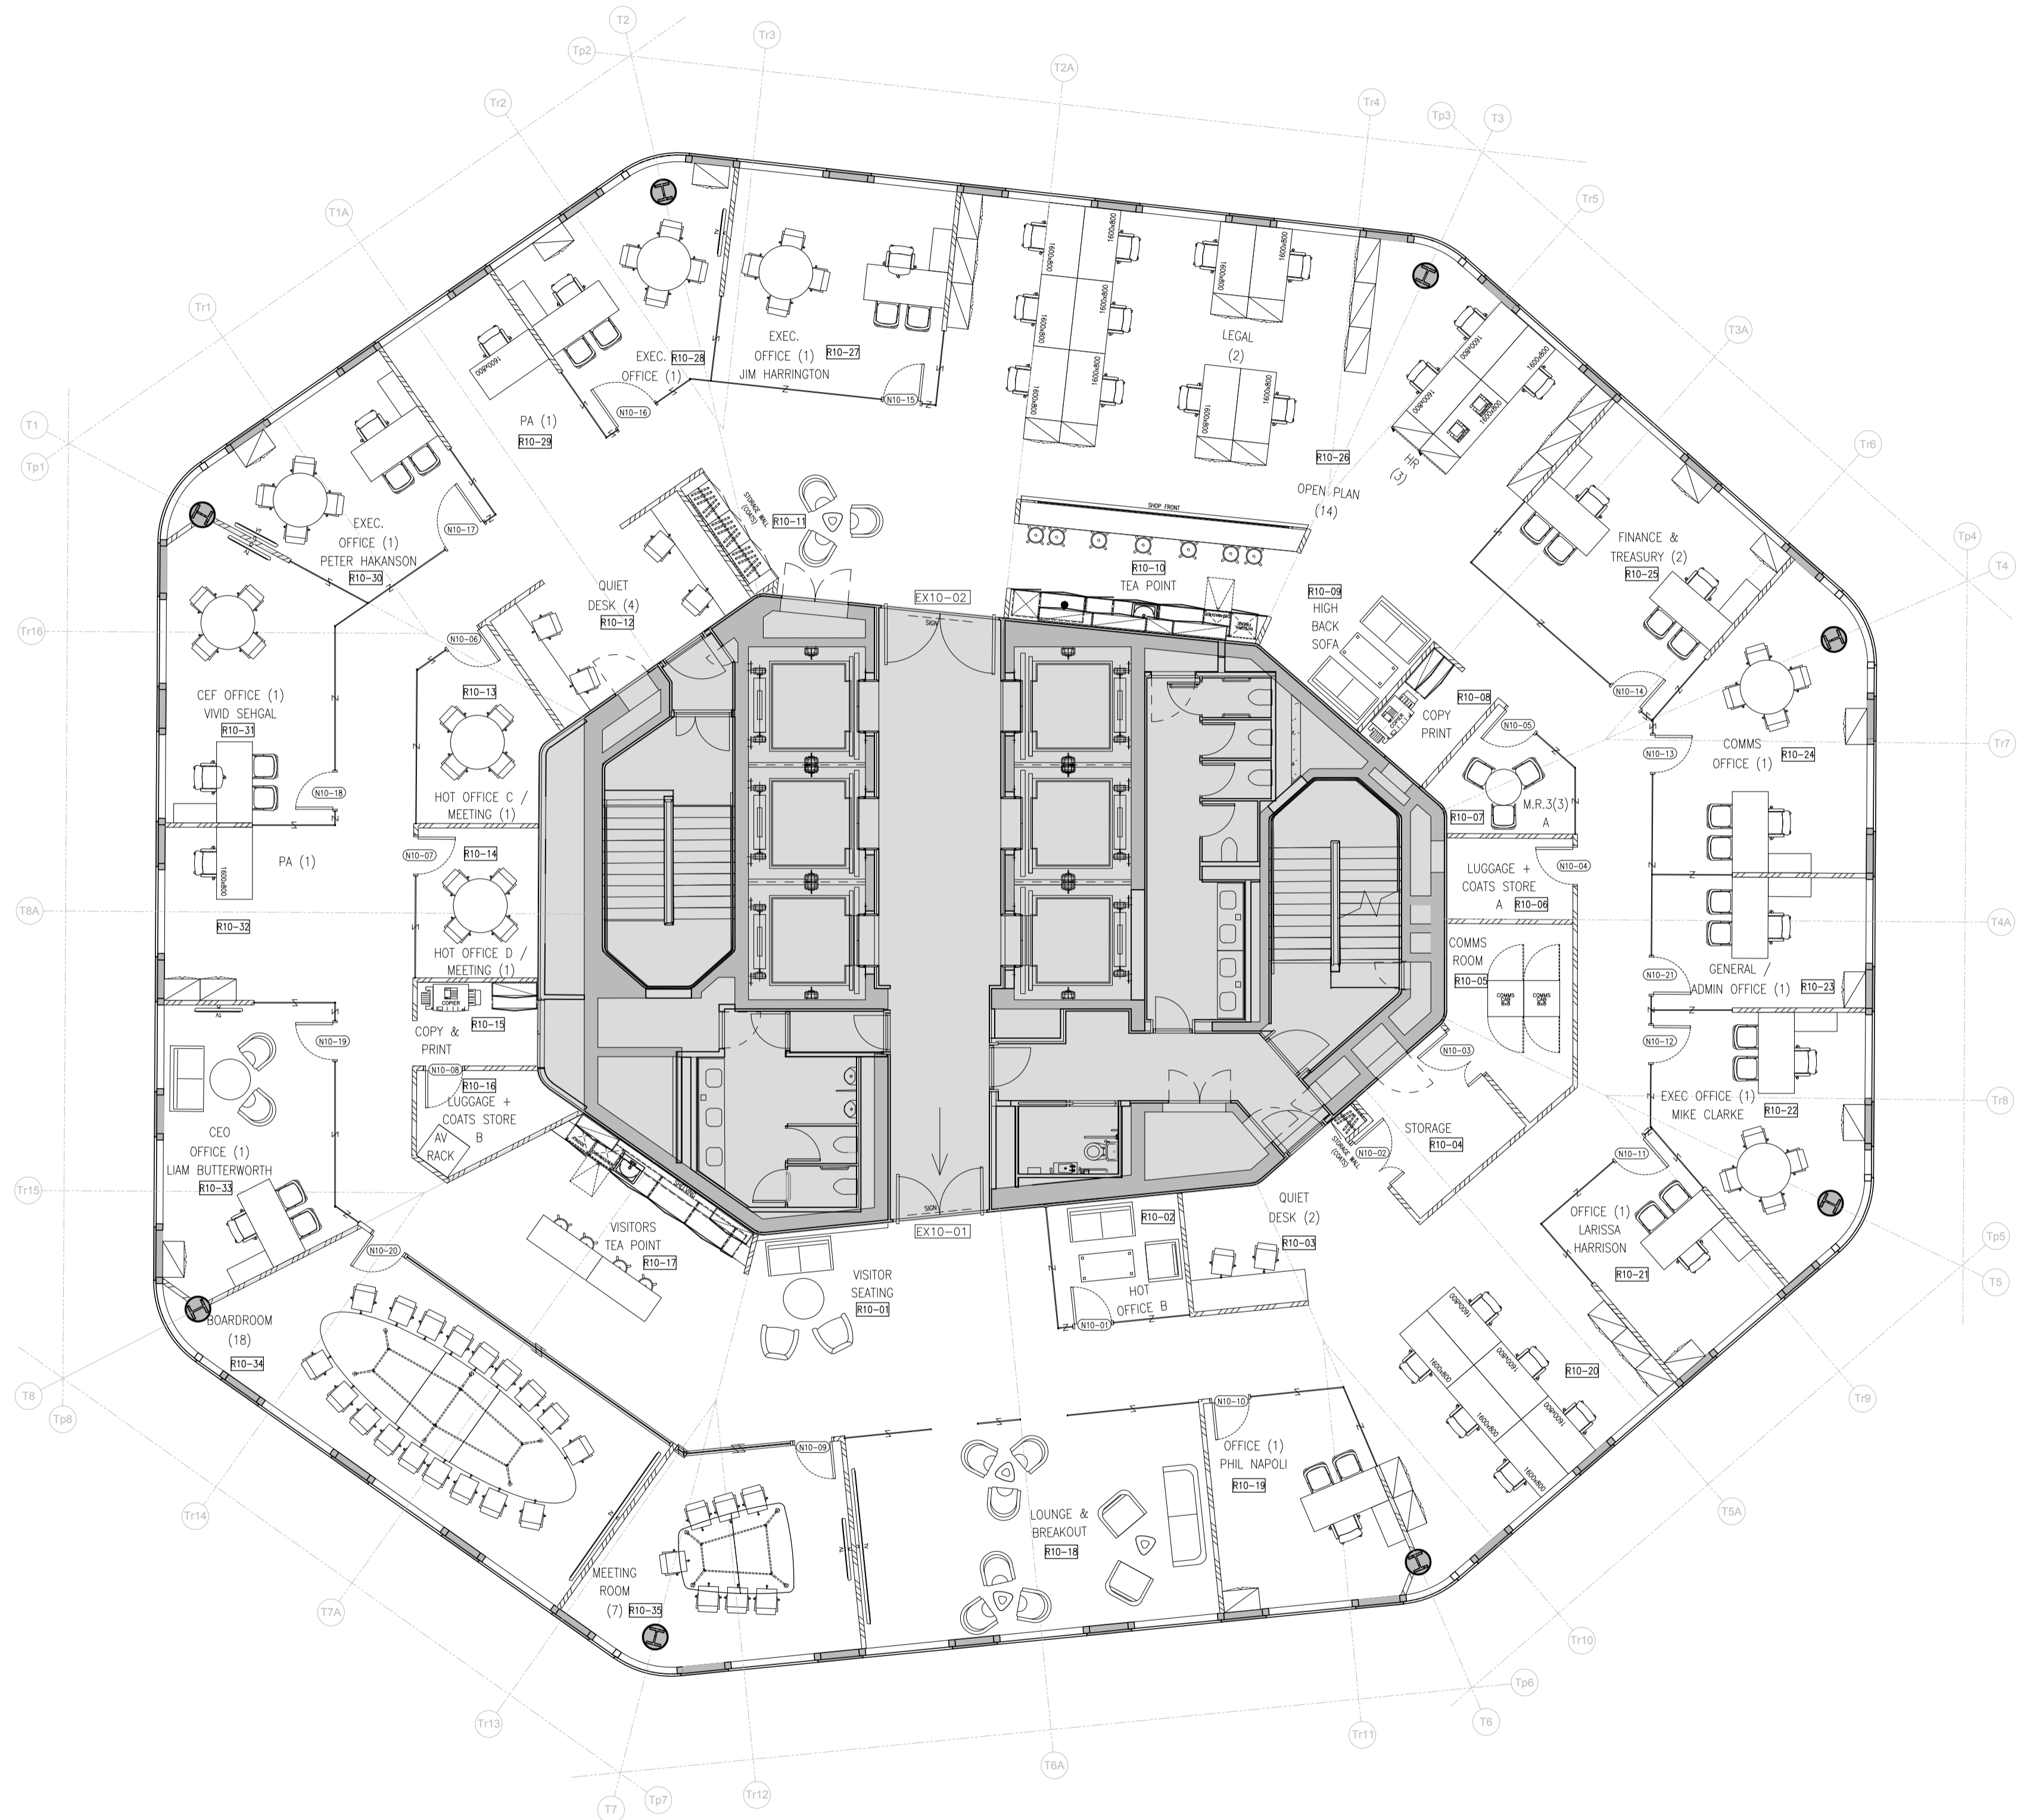

**KEY TO GENERAL ARRANGEMENT DETAILS**

Keys not to scale - Some symbols shown might not appear on the drawing

- Existing structural basebuild wall
- Existing partition
- New 75mm solid stud partition (Single skin)
- New 100mm solid stud partition (Single skin)
- New 100mm solid stud partition (Double skin)
- New partition(Detail t.b.c.)
- New partition(Detail t.b.c.)

Note:- All partitions to be 'raised floor to underside of suspended ceiling' - Unless otherwise noted (See below)

**GLAZING DETAILS**

- Existing silicon glass
- Existing glazed module
- New single glazed silicon glass
- New double glazed silicon glass
- New single glazed module
- New double glazed module

**DOOR DETAILS**

- Existing door
- Relocated door
- New solid framed door
- New glass door
- EX1=Existing 1st floor
- RX1=Relocated 1st floor
- N1 = New 1st floor
- VP Vision Panel
- SEC Security door
- FD205 Fire door rated with smoke seal
- FD205 = 20min
- FD305 = 30min
- FD605 = 60min
- Standard height doors unless otherwise stated
- Full height doors unless otherwise stated
- R1 = 1st floor room
- W1 = 1st floor window
- 01 = Room no.
- 01 = Window no.

Comms floor Vinyl floor Wood floor Tiled floor

Existing furniture New furniture Expansion furniture

Low height (Tambour unit) Medium height (Drawer unit) High height (Door unit)

General Storagewall Cloaks Storagewall Roller Storage

Credenza Racking System Filing Cabinet

REV	DESCRIPTION	BY	DATE
<b>DRAWING STATUS</b>			
<b>AS BUILT</b>			
<b>QUALITY CONTROL</b>			
MARIS	signed:		
	DATE:		
CLIENT	signed:		
	DATE:		

Property & Copyright © MARIS INTERIORS LLP  
Use of drawings is not permitted nor can they be copied, duplicated or distributed without the consent of the LLP.  
All designs are the sole property of MARIS INTERIORS LLP and may not be used, transferred or copied in a third party without the express permission of MARIS INTERIORS LLP. Drawings, copies of this drawing are supplied for consultation only. No dimensions or other information should be used from the drawings. They do not constitute the contract. Signed drawings only can be used for construction. All the drawings are the property of the client's firm. Permission to use the drawings, text, and components is only given for the construction of the work, otherwise the contractor shall be responsible for any associated cost. Any claims for variations or extra work shall be submitted to the client for approval prior to the commencement of the work, otherwise the contractor shall bear the responsibility for any associated cost. This drawing is to be used for information only. It is not a contract. Check names, addresses etc. subject to statutory approval. All dimensions shown are in millimetres unless otherwise stated.

**Delphi Automotive Systems UK Ltd**

Address  
Angel Court  
London  
EC2R 7BH

Project Number	Ref	Floor	Detail
22389	01	10	GA

Drawing Title  
**10th Floor - General Arrangement**

Produced by	Scale	Amended date	Rev
SA	1:100@A1	24/11/2017	AB

**MARIS INTERIORS LLP**  
The Harcourt Building  
65 Southmark Street  
London SE1 0NR

T 020 7502 1750  
E maris@maris-interiors.co.uk  
W www.maris-interiors.co.uk