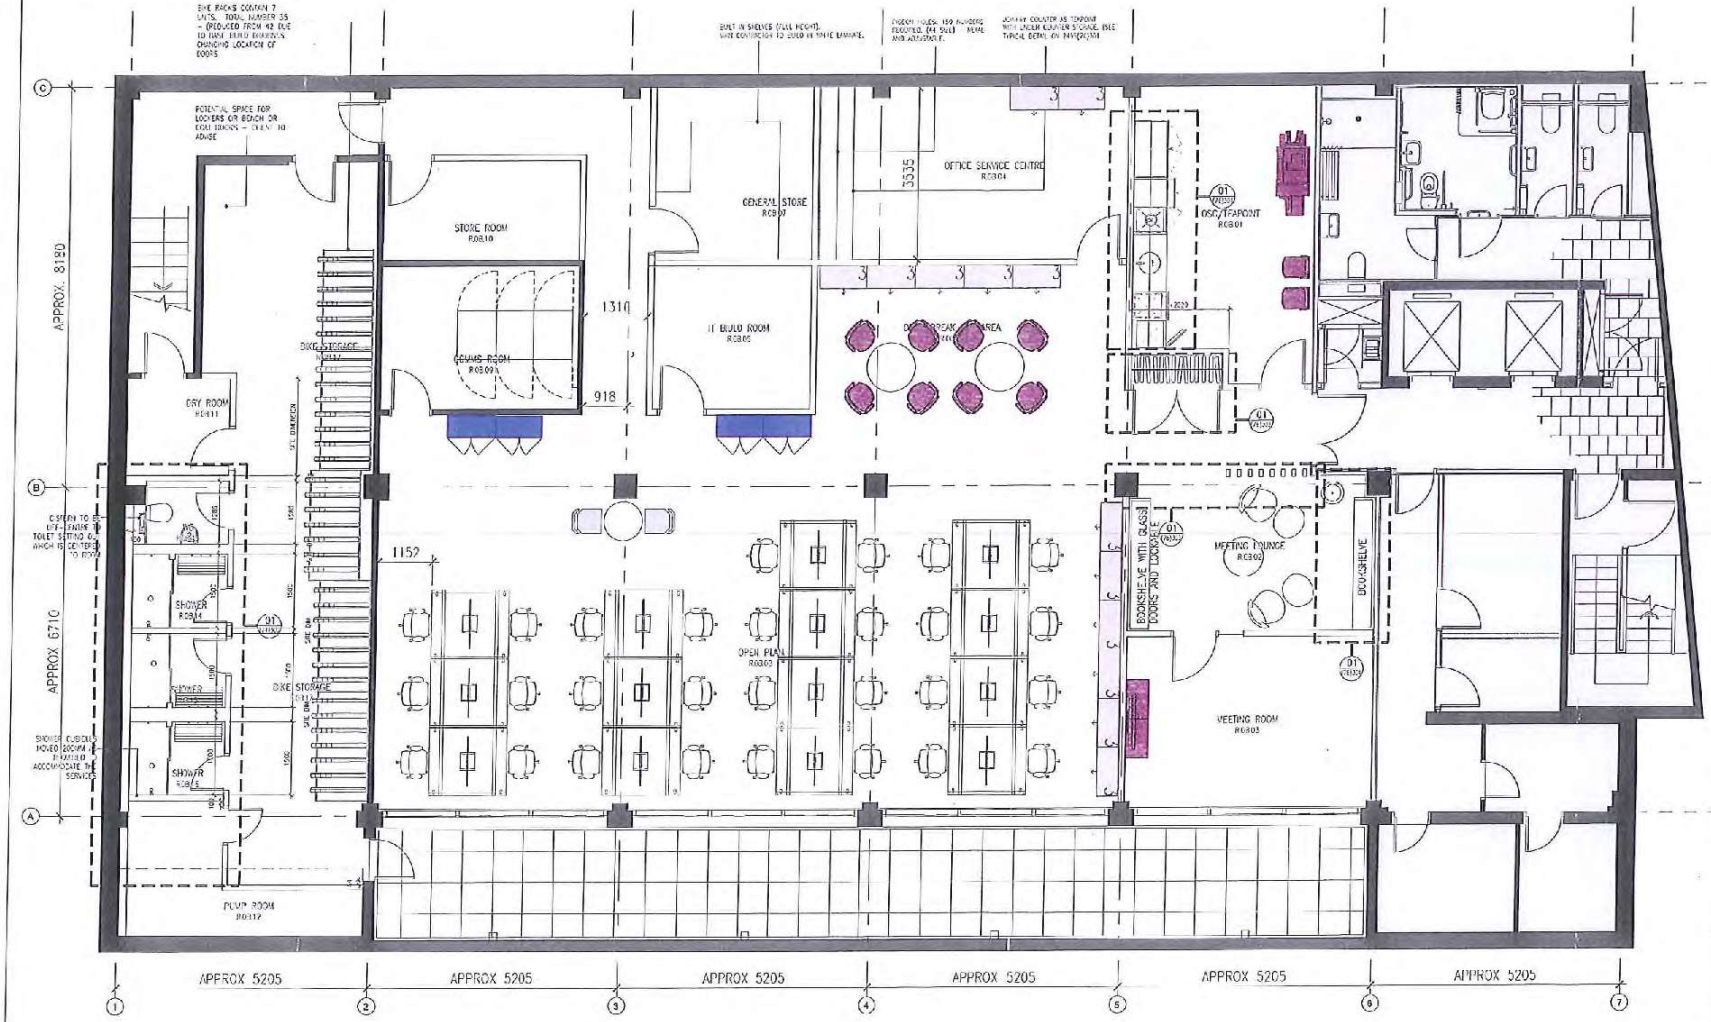

SCALE BAR IN MM

DO NOT SCALE ANY DIMENSIONS OFF THIS DRAWING. ANY DISCREPANCIES BETWEEN THIS DRAWING AND OTHER INFORMATION ARE TO BE REFERRED TO MCM ARCHITECTURE LIMITED. WHERE THE DRAWING REFERS TO AN EXISTING BUILDING OR COMMENCED CONSTRUCTION THE CONTRACTOR IS RESPONSIBLE FOR CHECKING THAT THERE IS NO CONFLICT BETWEEN ACTUAL BUILDING DIMENSIONS AND TRADE DRAWINGS. IN THE EVENT OF DISCREPANCIES BETWEEN THIS DRAWING AND SUBCONTRACTORS APPROVED WORKING DRAWINGS FOR EXTENSIVE BUILDING COMPONENTS, THE SUBCONTRACTORS DRAWINGS SHALL TAKE PRECEDENCE. ANY CONFLICTS ARISING DUE OF INFORMATION AS NOTED ABOVE JUST BE PRESENTED TO MCM ARCHITECTURE LIMITED. THIS DRAWING IS THE COPYRIGHT OF MCM ARCHITECTURE LIMITED. ALL DIMENSIONS ARE IN MILLIMETRES UNLESS OTHERWISE STATED.

REV	DATE	PURPOSE OF ISSUE	BY
A01	13.09.12	AS BUILT DRAWING	DH

CLIENT: ODI

PROJECT: 203 BLACKFRIARS ROAD

DRAWING: BASEMENT FLOOR GENERAL ARRANGEMENT LAYOUT

SCALE: A1 @ 1:50/A1
CAD FILE: 2495(10)099.dwg
DRAWN: DH
CHECKED: MRJ

STATUS: ☐ PRELIMINARY ☐ TENDER ☐ CONSTRUCTION ■ AS BUILT

DRAWING NO: 2495(10)099 REV: AB1

MCM

MCM Architecture Limited T 020 7620 9200 F 020 7928 9203
71 Hopton Street London SE1 8LR www.mcmarch.com