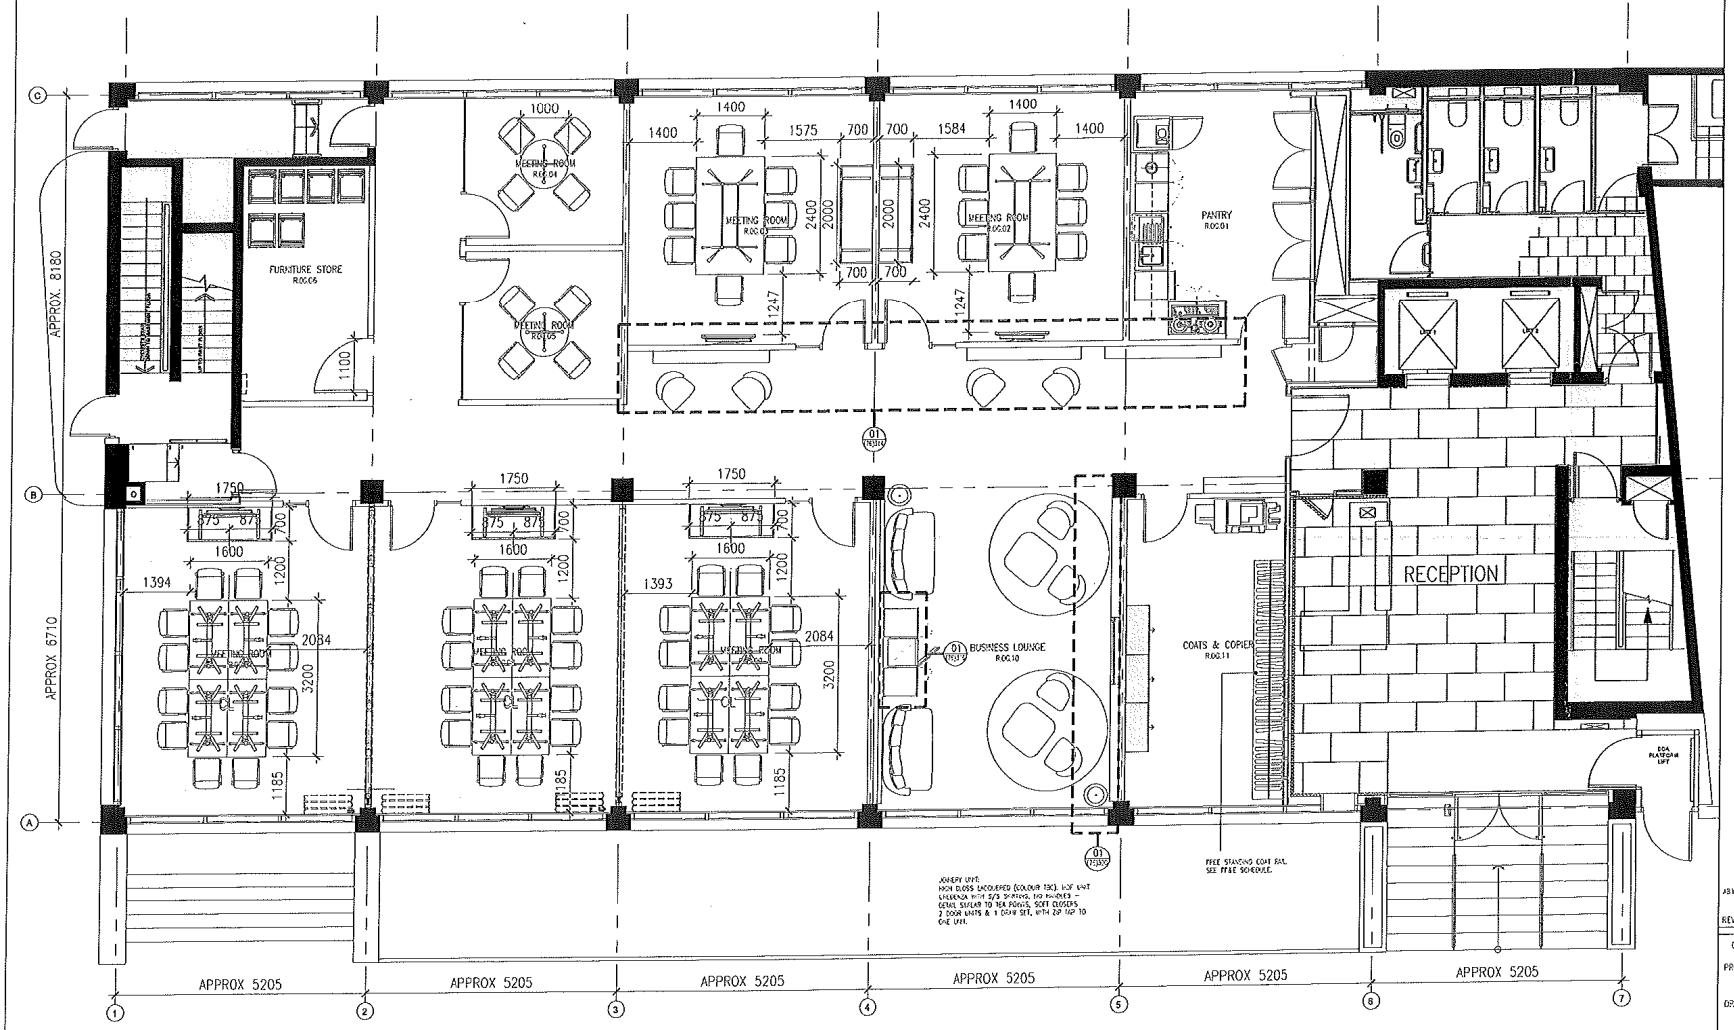


SCALE BAR IN mm

DO NOT SCALE ANY DIMENSIONS OFF THIS DRAWING. ANY DISCREPANCIES BETWEEN THIS DRAWING AND OTHER INFORMATION ARE TO BE REFERRED TO MCM ARCHITECTURE LIMITED. WHERE THE DRAWING RELATES TO AN EXISTING BUILDING OR COMPLEX CONSTRUCTION THE CONTRACTOR IS RESPONSIBLE FOR CHECKING THAT THERE IS NO CONFLICT BETWEEN ACTUAL BUILDING DIMENSIONS AND DRAWING DIMENSIONS. IN THE EVENT OF DISCREPANCIES BETWEEN THIS DRAWING AND SUBCONTRACTOR'S APPROVED WORKING DRAWINGS FOR RELEVANT BUILDING COMPONENTS, THE SUBCONTRACTOR'S DRAWING SHALL TAKE PRECEDENCE. ANY CONFLICTS ARISING OUT OF INFORMATION AS NOTED ABOVE MUST BE REPORTED IMMEDIATELY TO MCM ARCHITECTURE LIMITED. THIS DRAWING IS THE COPYRIGHT OF MCM ARCHITECTURE LIMITED. ALL DIMENSIONS ARE IN MILLIMETRES UNLESS OTHERWISE STATED.

| REV | DATE | PURPOSE OF ISSUE | BY |
|---|---|---|---|
| AB1 | 13.09.12 | AS BUILT DRAWING | DH |

CLIENT: ODI

PROJECT: 203 BLACKFRIARS ROAD

DRAWING: GROUND FLOOR GENERAL ARRANGEMENT LAYOUT

SCALE: A1 @ 1:500@A1
CAD FILE: 2495(10)100.dwg
DRAWN: DH
CHECKED: MRV

STATUS: ☐ PRELIMINARY ☐ TENDER ☐ CONSTRUCTION ☒ AS BUILT

DRAWING NO.: 2495(10)100 REV: AB1

MCM
MCM Architecture Limited T 020 7902 0900 F 020 7902 1233
21 Hopton Street London SE1 9LR
www.mcmarch.com

M:\2495 - ODI (Bank Parking Garage)\Cad\FileServer\2495(10)100.dwg
By: DH Date: 13.09.12 Time: 12:43
Plot: 2495(10)100 2495(10)100 2495(10)100 2495(10)100